


Note:  
 Hangar Floor Area 88m<sup>2</sup>  
 Accomodation Floor Area 66m<sup>2</sup>  
 Total Floor Area 154m<sup>2</sup>



Water Tank  
 Product Code RT22500  
 Capacity 22,500 litres (5,000 gallons)  
 Diameter (mm) - 3570  
 Wall Height (mm) - 2355  
 Total Height (mm) - 2890

Internal Layout

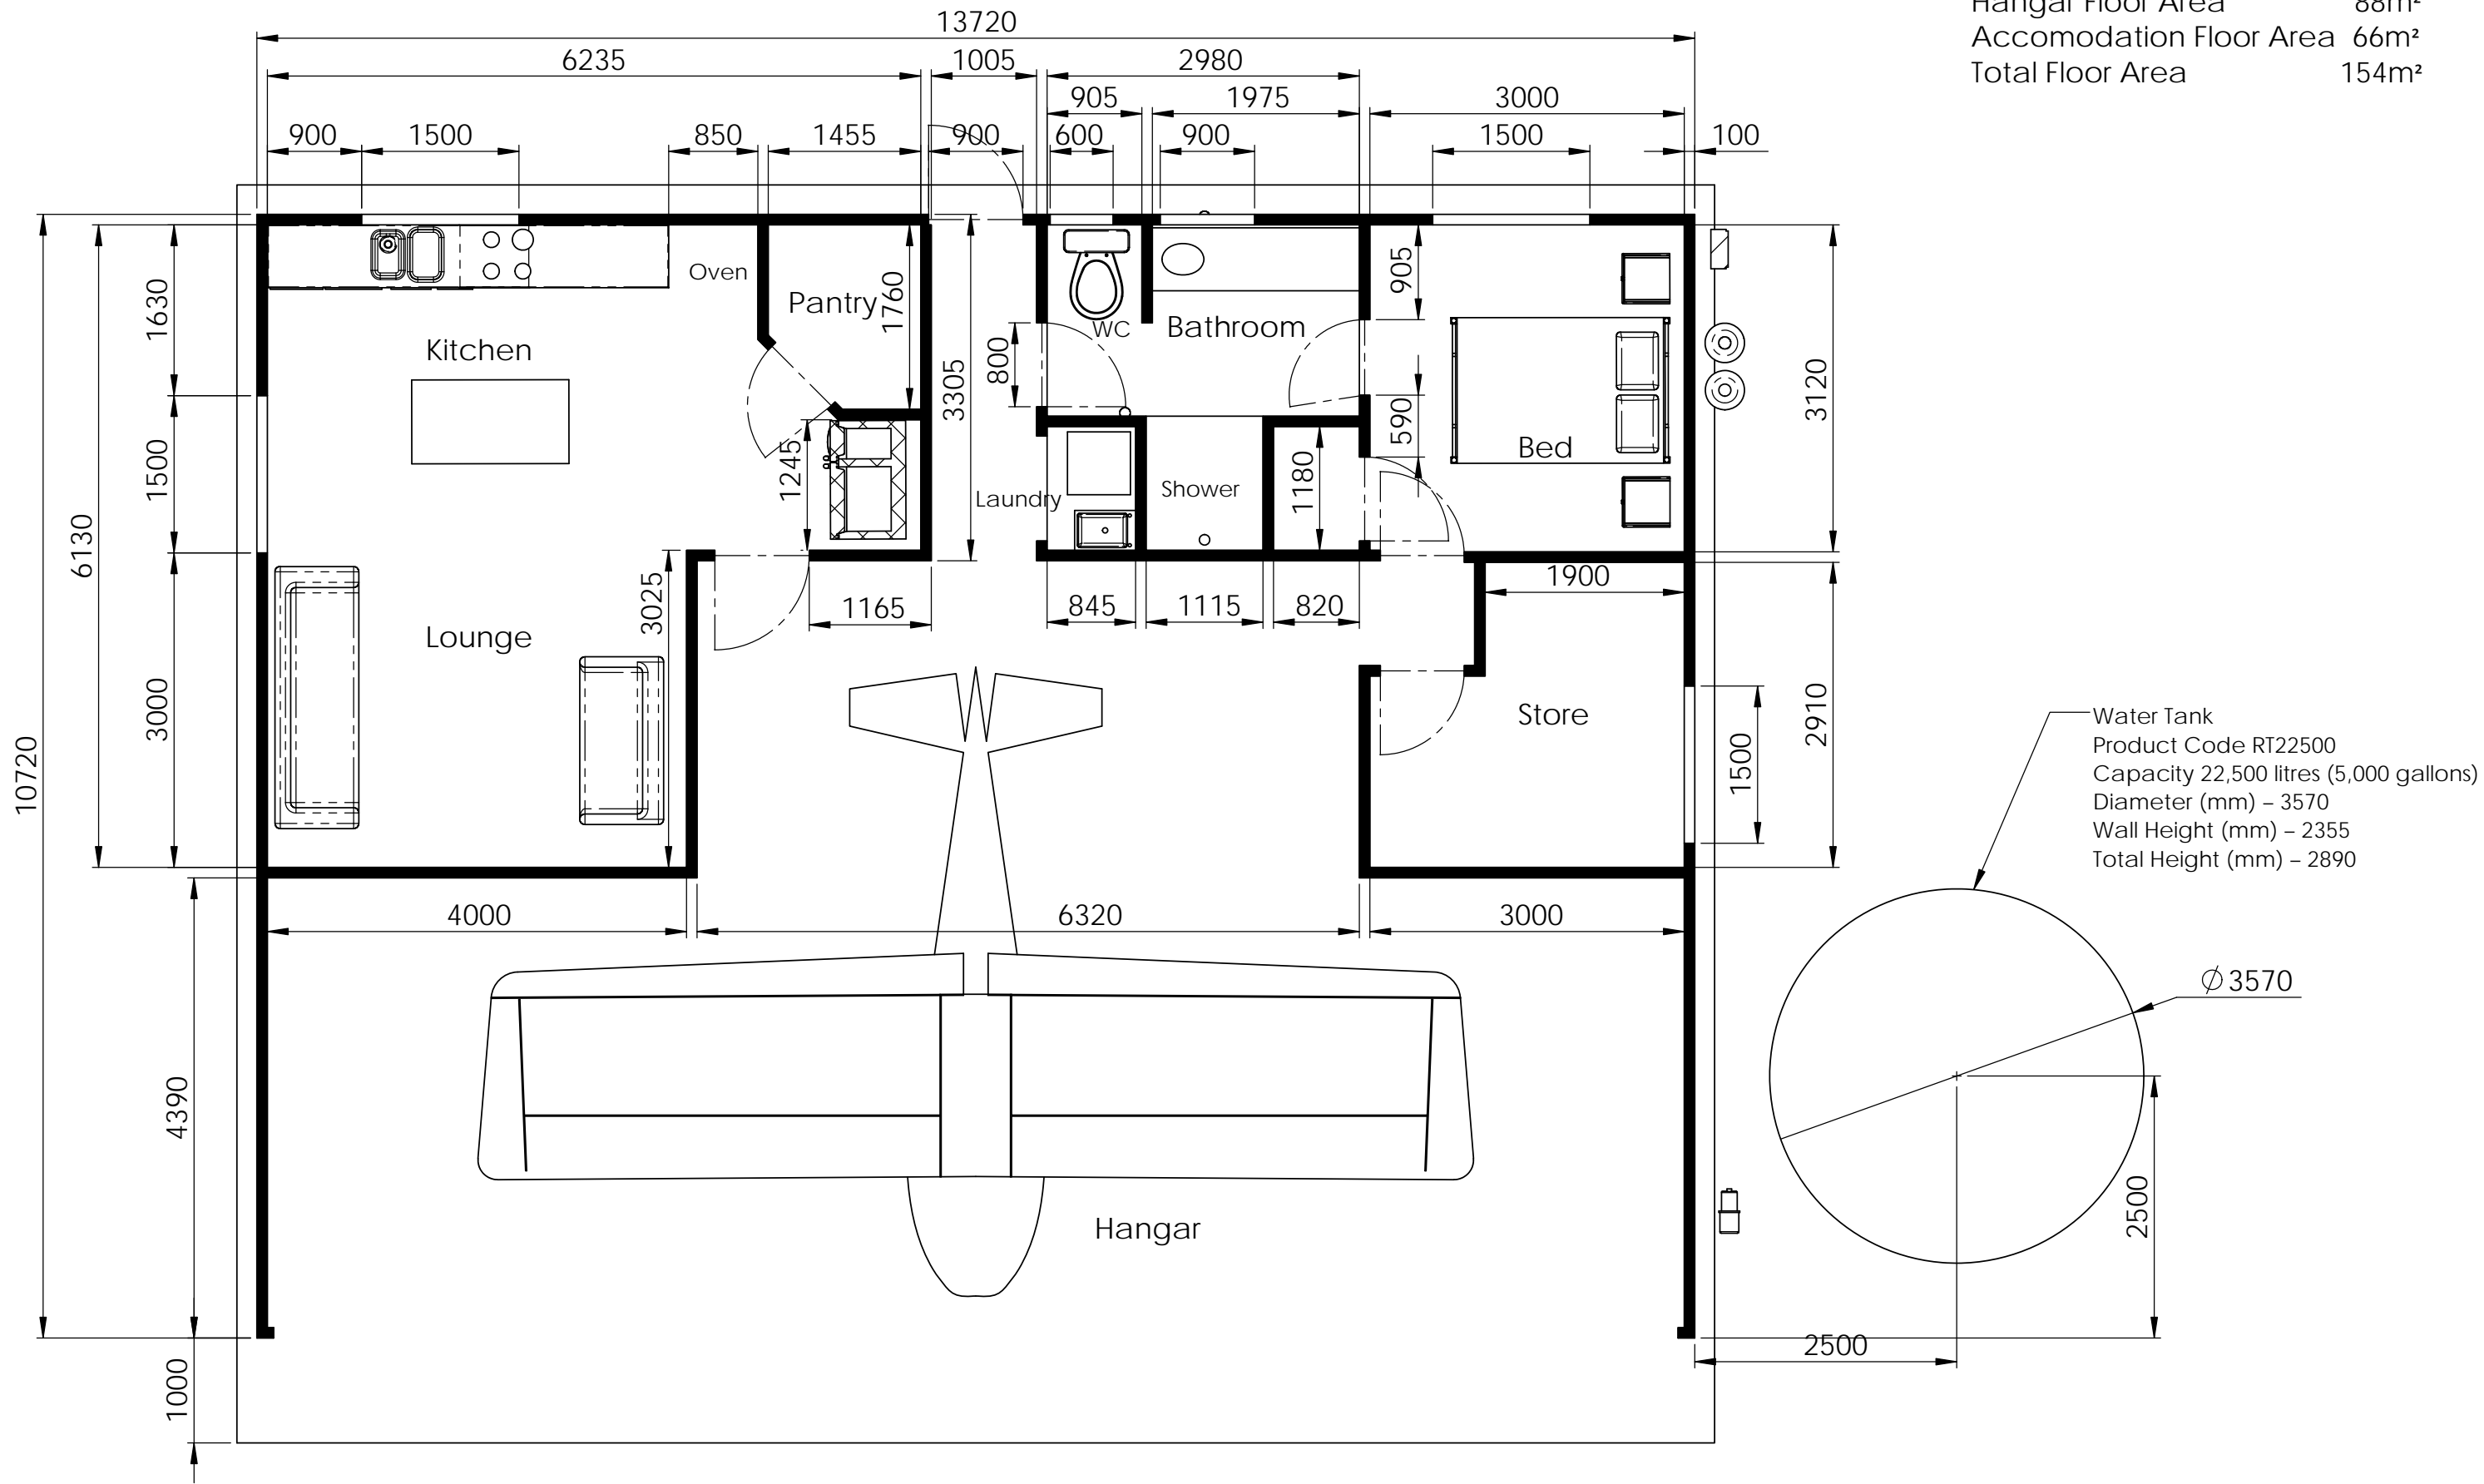

TOLERANCES:  
 ONE PLACE DECIMAL ± 0.1  
 TWO PLACE DECIMAL ± 0.05  
 THREE PLACE DECIMAL ± 0.02  
 ANGULAR: MACH ± 0.1  
 ALL WELDS U.N.O. 6  
 DO NOT SCALE DRAWING

DRAWN	Ajc	27-07-2016
CHECKED	-	-
ENG APPR	NONE	-
THE INFORMATION CONTAINED IN THIS DRAWING IS THE SOLE PROPERTY OF YWGM. ANY REPRODUCTION IN PART OR AS A WHOLE WITHOUT THE WRITTEN PERMISSION OF YWGM IS PROHIBITED.		

White Gum Air Park - YWGM Tel: 0400 246906 Tel: 0401 279 773	
Hangar Apartment H01 - Fred Selly	
SIZE A3	DWG. NO. A2015-0315-H1
SCALE: 1:60	WEIGHT: 0 Kg
SHEET 1 OF 10	

REV.  
4